Barton Creek Greenway

Financial Information

NCDOT GRNT - CMAQ		CMAQ\$	CMAQ %
NCDOT GRNT -Original Grant Amount (2012)	\$	881,280	80%
NCDOT GRNT - Additional grant funding (Jan 2018)	\$	1,383,870	80%
NCDOT GRNT - New Additional grant funding (Sept 2018)	\$	500,000	80%
NCDOT GRNT Total:	\$	2,765,150	80%
	Cou	nty Local Match	County Local Match
Local Match Required	\$		%
Local Match -Original Grant Amount (2012)		\$220,320	20%
Local Match - Additional grant funding (Jan 2018)		\$345,968	20%
Local Match - New Additional grant funding (Sept 2018)		\$100,000	20%
Local Match Total:		\$666,288	20%

Revised Total Project Budget	\$ 3,431,438

County Funds	
011A-Original County Matching Funds (2012)	\$ 267,320
PAYG-Other County Funds allocated to project (2015)	\$ 525,000
Additional Funds Available:	\$ 792,320

Prepared by Jay Higginbotham on 1/23/2018 Revised by Joyce Figueroa on 1/29/2019

INDEX OF SHEETS COVERSHEET GENERAL NOTES .. TYPICAL SECTIONS... DETAIL SHEETS 2-C TO 2-D PLANTING DETAIL SHEET CONCRETE STAIR DETAILS SANITARY SEWER DETAILS DRAINAGE SUMMARY TABLE PLAN SHEETS. 1109 RESIDENT SITE PLAN PROFILE SHEETS 11 TO 17 - EC-1 TO EC-10

. RW-1 TO RW-5

S-1 TO S-8

UBO-1 TO UBO-6

CROSS SECTIONS

STRUCTURE PLANS..

RETAINING WALL PLANS ...

UTILITY BY OTHERS PLANS


PROJECT AREA



Construction Plans of Proposed

BARTON CREEK GREENWAY (JW CLAY BLVD. - MALLARD CREEK GREENWAY)

TIP PROJECT NO. = C-5537WBS ELEMENT NO. = 51007.1.1FEDERAL PROJECT NO. = CMS - 1003 (119)

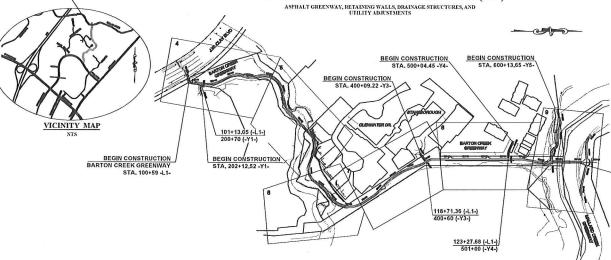

END CONSTRUCTION
BARTON CREEK GREENWAY 127+6.10 (-L1-) 701+68,13 (MALLARD CREEK)

PE SEAL

Record Drawings

LOCATION MAP

-Y2- REMOVED FROM PLANS

PROJECT LENGTH = 0.52 MILES D.S. 20 MPH

PLANS PREPARED BY:

NC LICENSE #F-0102 200 South Tryon Street Suite 200 Charlotte, North Carolina 28202 Phone: (704) 333-5131



2/28/2017

GRAPHIC SCALES			
Plan View	20	40	60
Horz, Profile	20	40	60
	1	8	12
Cross Section		10	15

R RELIANCE ON THIS DOCUMENT WITHOUT WRITTEN AUTHORIZATION AND ADAPTATION BY KINGEY-HOPN AND ASSOCIATES, INC. SHALL BE MITHOUT LIABILITY TO KINGEY-HOPN AND A

CD I DIVIG COLL DO

2012 NCDOT STANDARD SPECIFICATIONS

Existing Gas Line Existing Water Line Existing Underground Telecommunication ----Existing Storm Drainage 0 Existing Tree . Existing Water Mete M. Existing Water Valve © X3 Existing Gas Valve . **Existing Sanitary Sewer Manhole** (3) Proposed Sanitary Sewer Manhole 0 Proposed Storm Drain Manhole .O Existing Telephone Manhole Ō. Proposed Telephone Manhole Ō. Existing Electric Manhole 3 Existing Catch Basin . Existing Light Pole .. Proposed Light Pole Existing Utility Pole Proposed Utility Pole Iron Pin .0 Proposed Fire Hydrant Existing Drop Inlet. . = Proposed Drop Inlet (ES) **@** Curb Cut for Future Ramp Tree Protection Proposed Curb & Gutter, Conc. Drive, Sidewalk

CONVENTIONAL SIGNS

Proposed Property Line ...

Existing Property Line .

Maintained as R/W Line

Proposed Edge of Pavement

Existing Structure

Railroad Tracks

Slope Stake Line



Bid Set No.

Proposed Asphalt Pavement

Proposed Pavement Removal Proposed Mill and Overlay Proposed Sidewalk Bridging Tree Roots Proposed Ditch Line ... Drainage Flow Path ..

Proposed Inlet Protection Proposed Saw Cut Line ...

Proposed Rip Rap Ditch

DATE COUNTY ENGINEER

777